2020 Comprehensive Street Maintenance Program - As Built
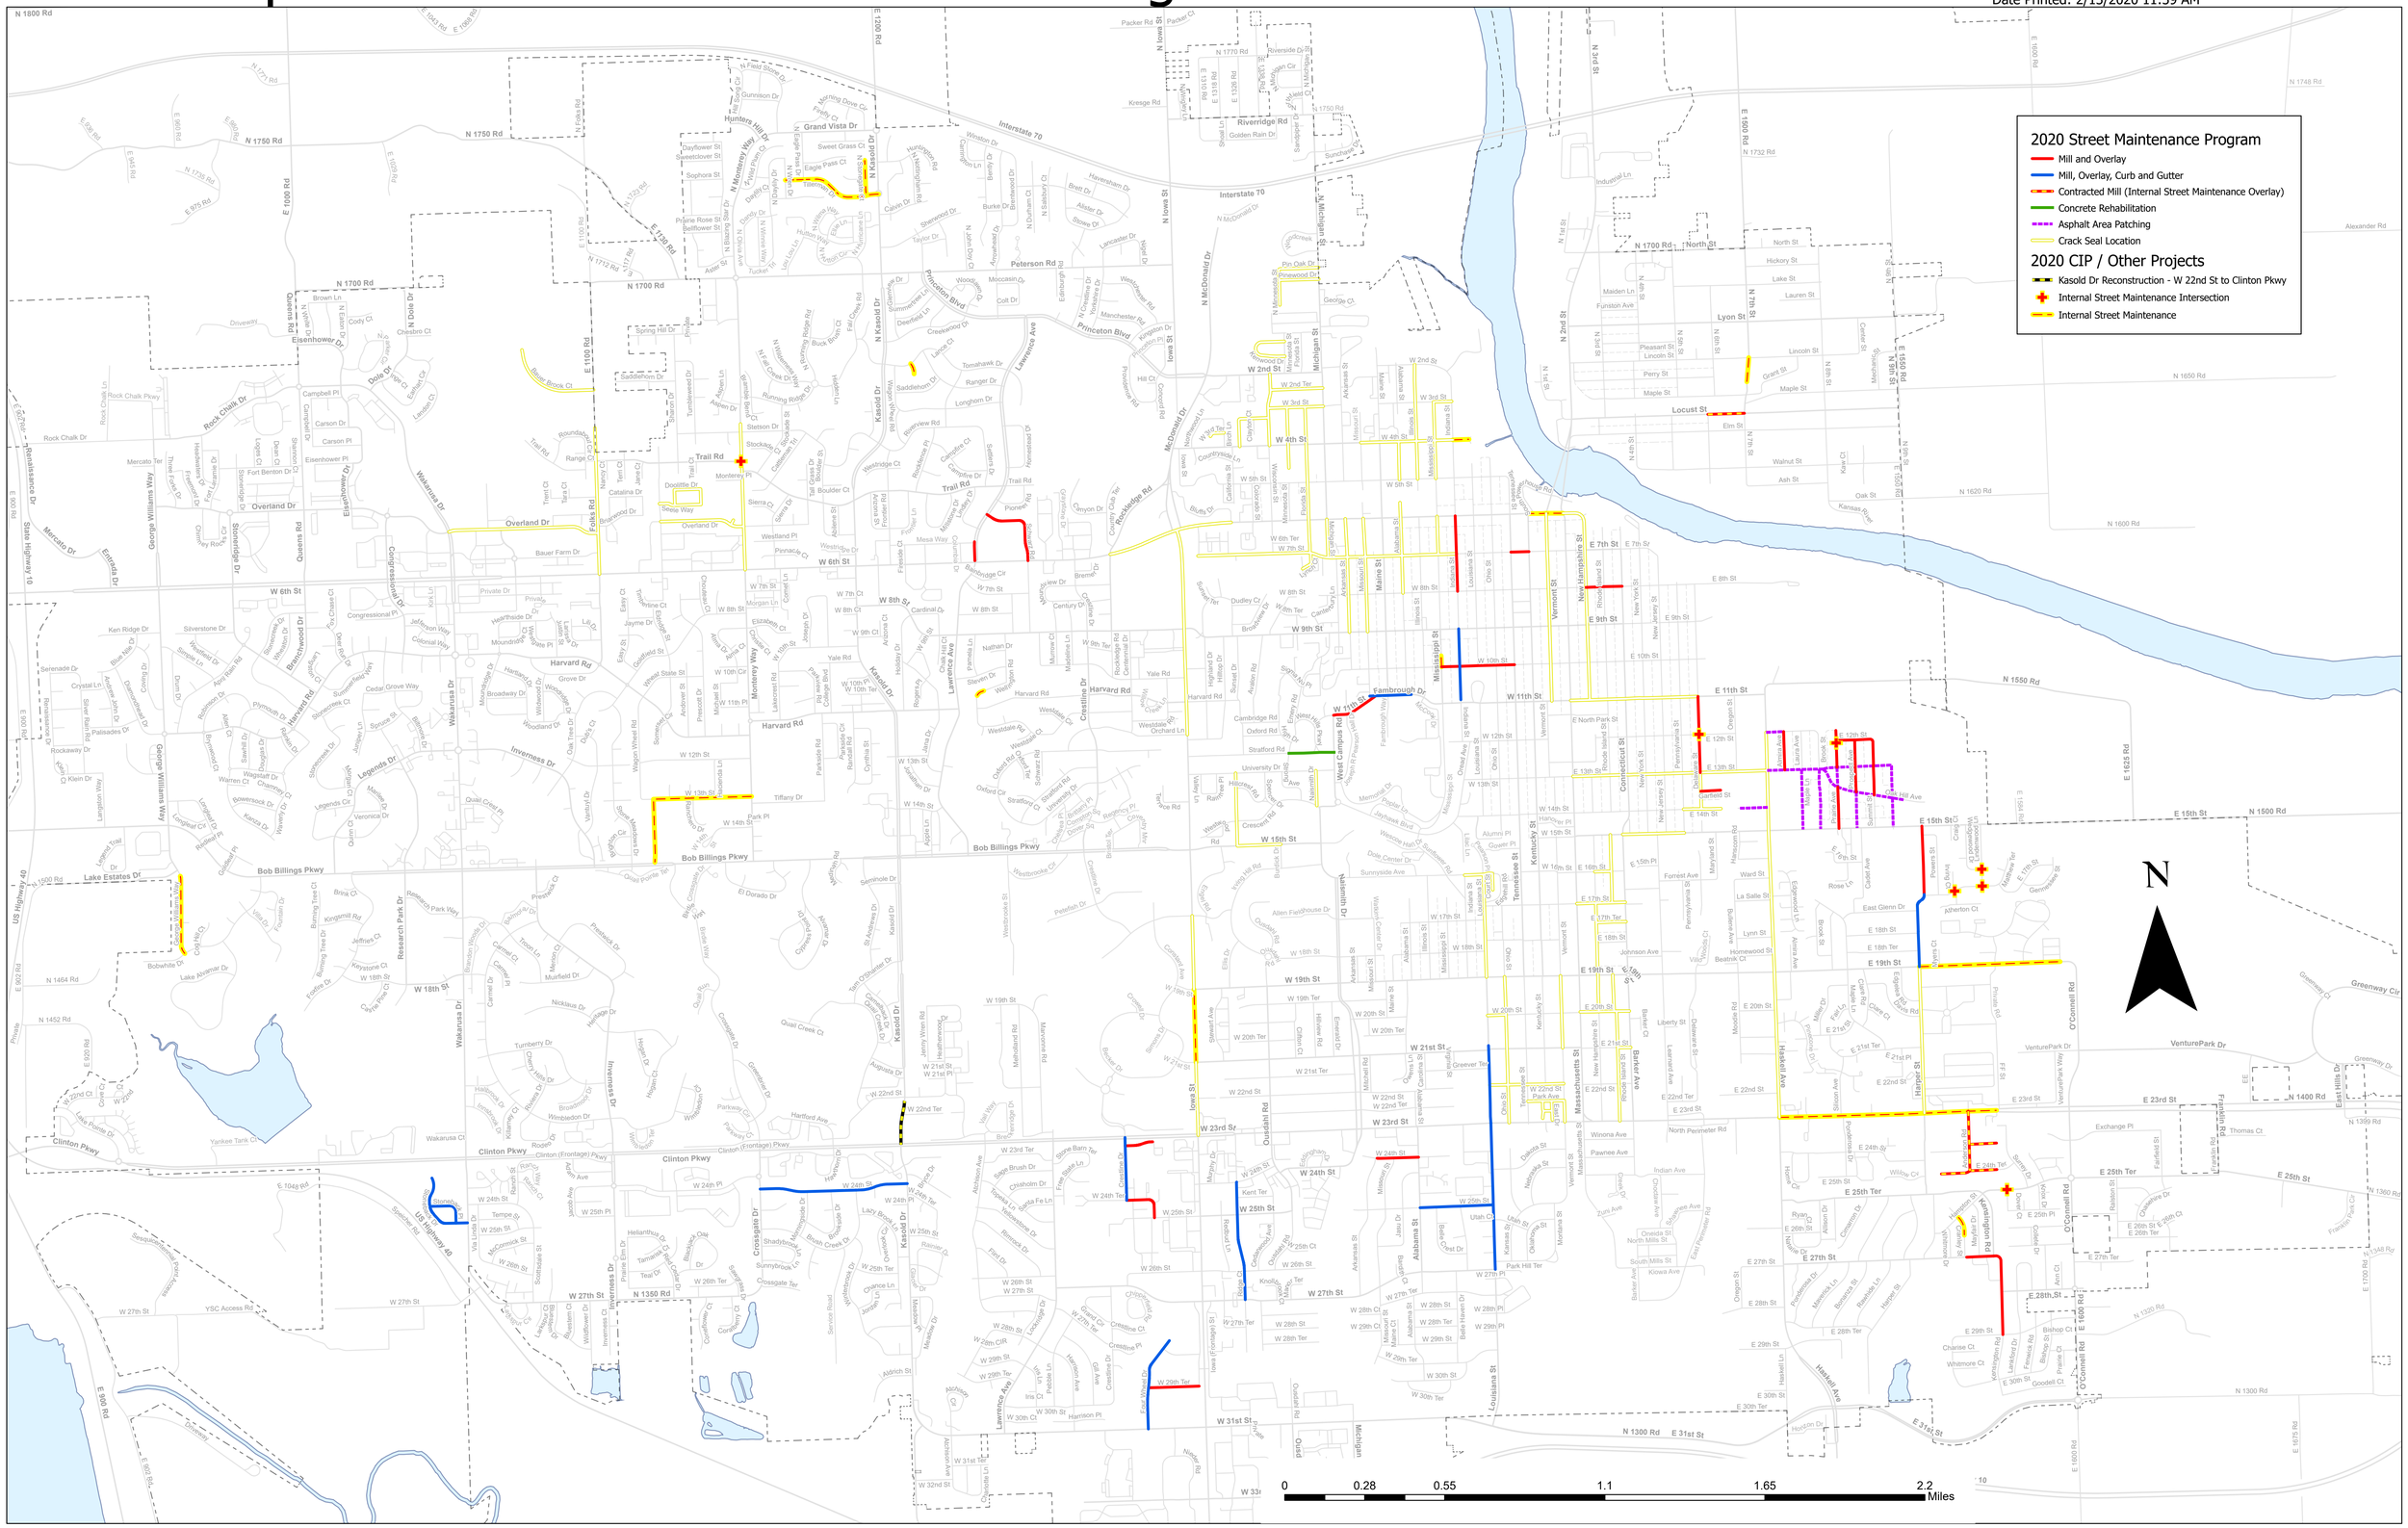
Date Printed: 2/13/2020 11:39 AM